
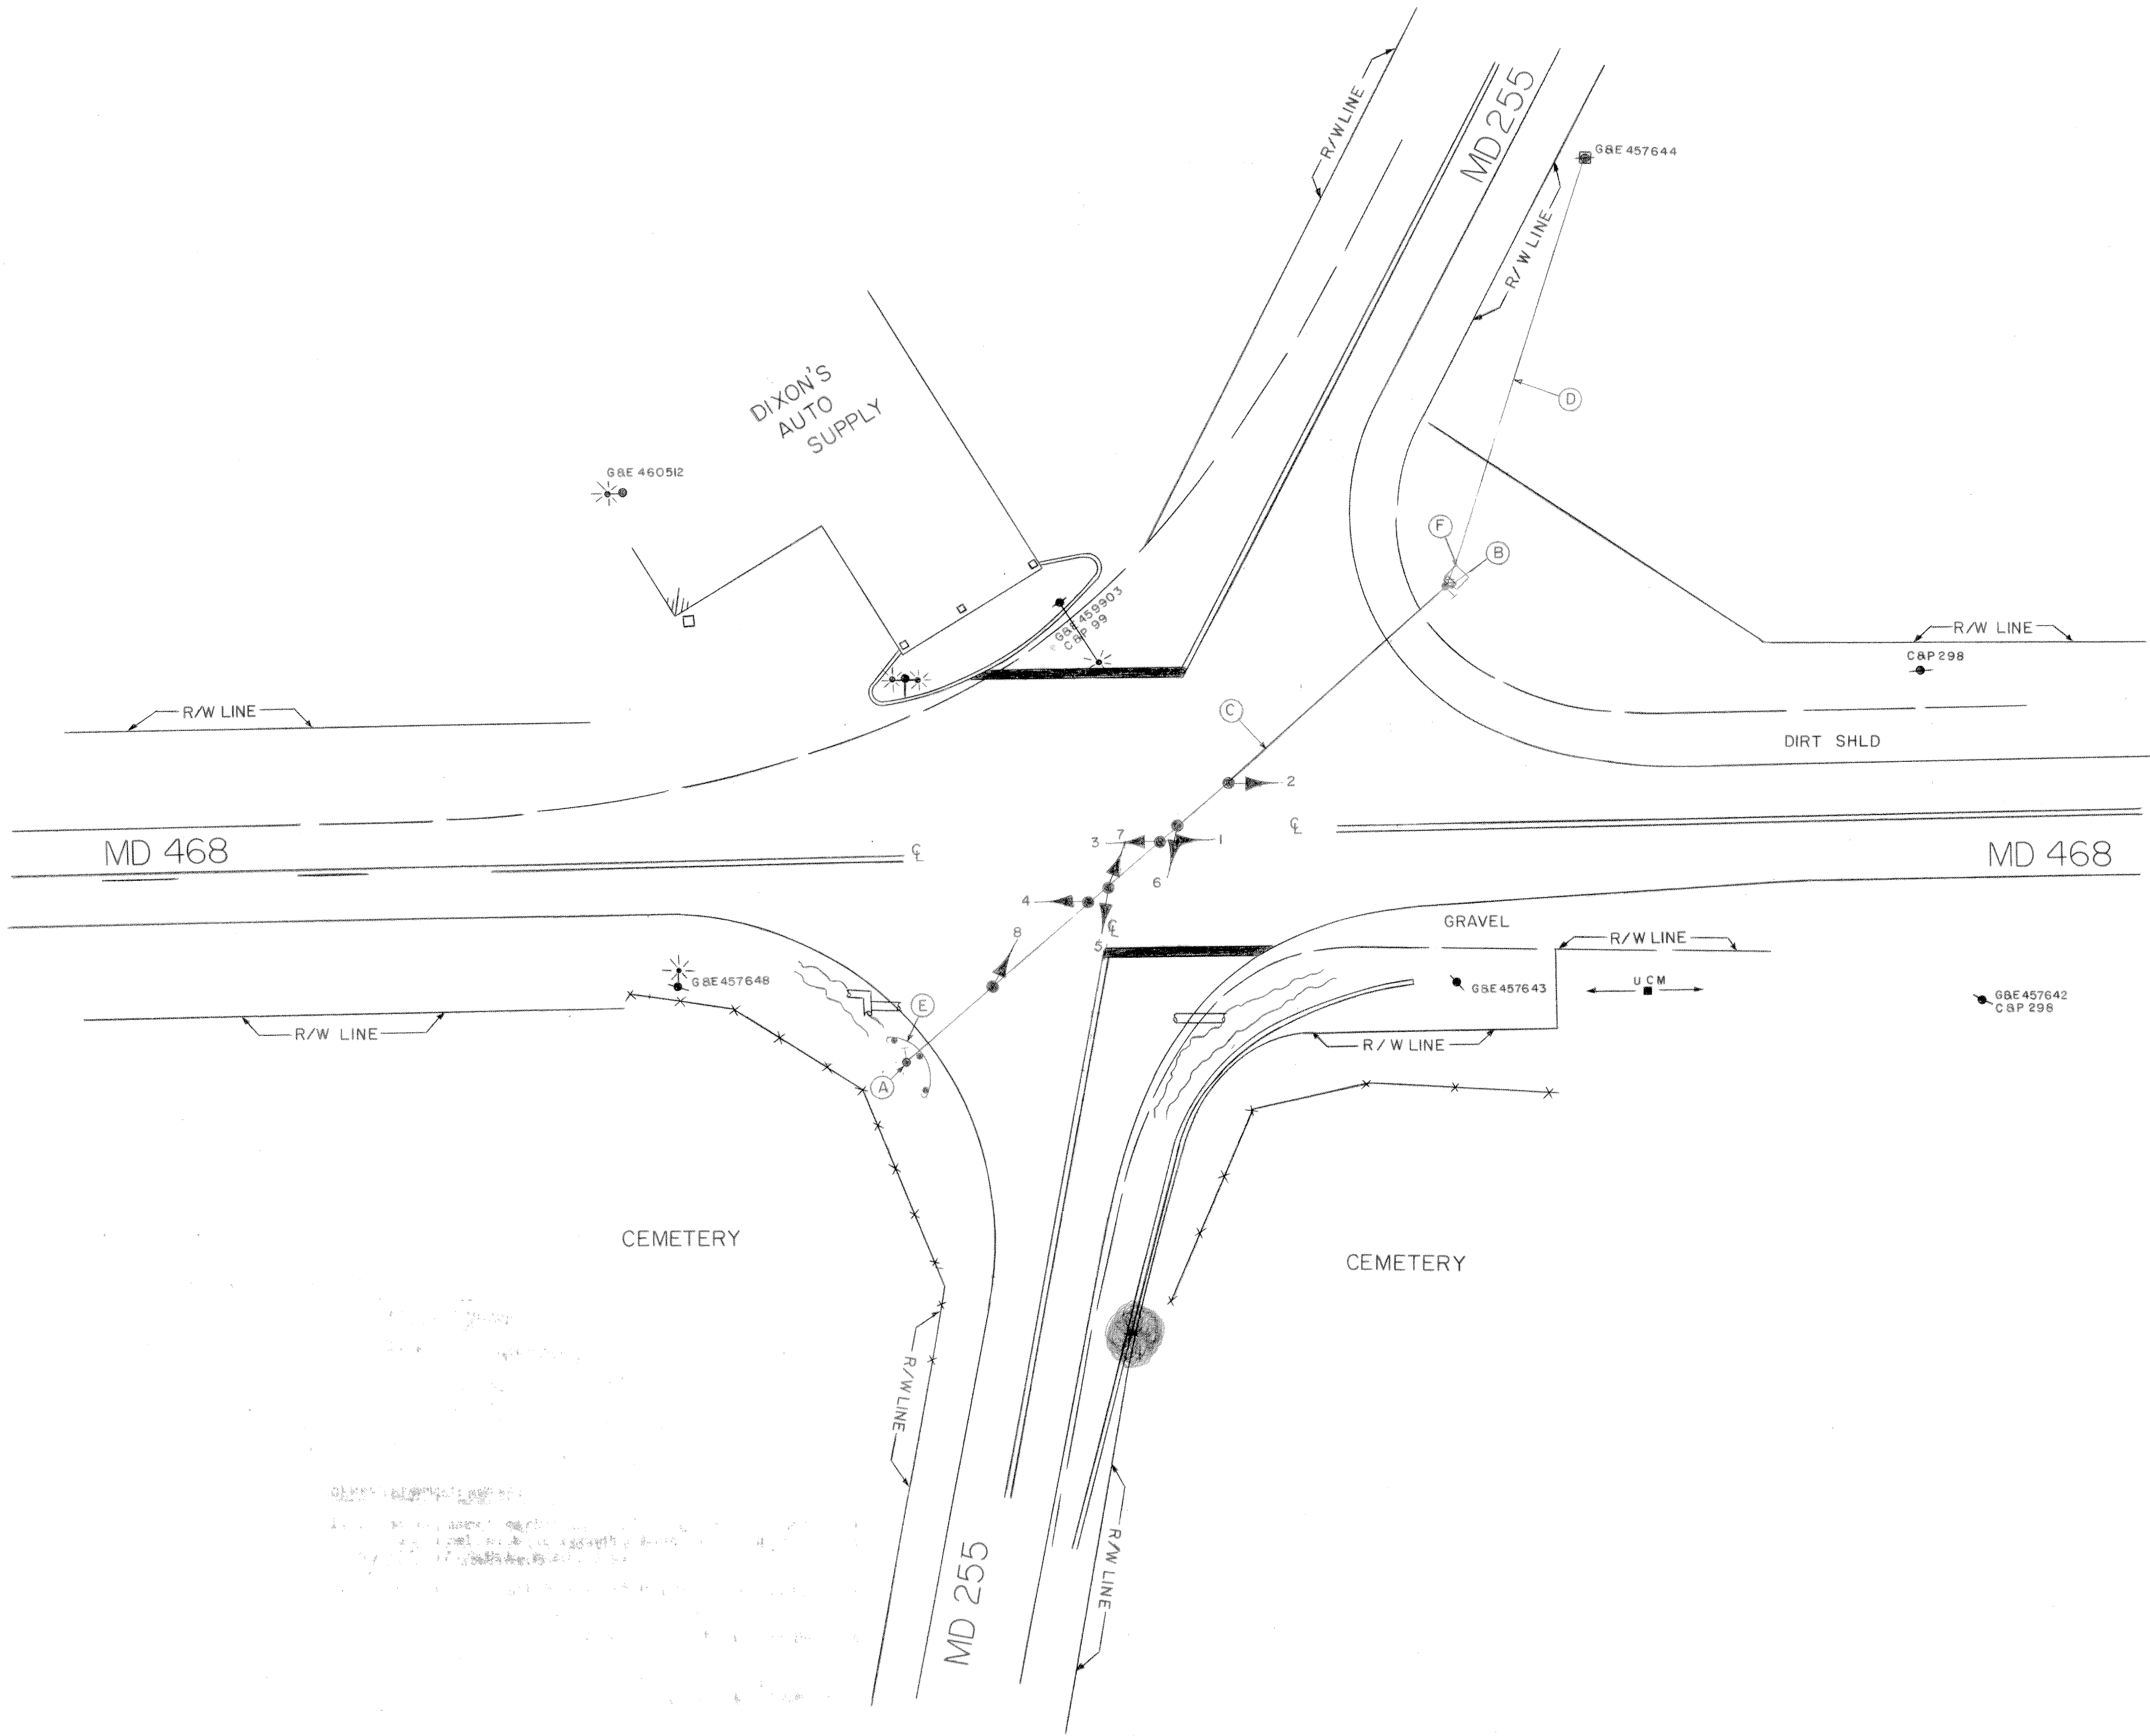


F.H.W.A. REGION NO.	STATE	FED. AID PROJ. NO.	SHEET NO.	TOTAL SHEETS
3	MD.			

SIGNALS
1-4 (Y) 5-8 (R)

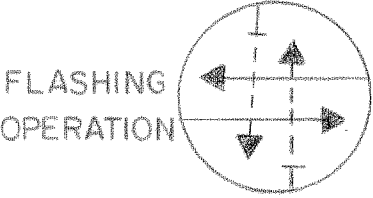

James E. Edick 6/12/75
APPROVAL: REGIONAL
TRAFFIC ENGINEER

Edward V. Pauls Jr. 6/12/75
APPROVAL: CHIEF BUREAU
OF
TRAFFIC ENGINEERING

Jim Hill 6-16-75
APPROVAL: ASST. CHIEF ENGINEER
TRAFFIC

A	12-18-78
ASBUILT	
AA 972X-000-585	
REVISIONS	

STATE OF MARYLAND
DEPARTMENT OF TRANSPORTATION
STATE HIGHWAY ADMINISTRATION
TRAFFIC DIVISION - BUREAU OF TRAFFIC ENGINEERING
MD 468 & MD 255
(GALESVILLE)

SCALE 1"=20' DATE 4-26-75 CONTRACT NO.

DRAWN BY: DIMITRIOS A ZAFIRIS COUNTY: ANNE ARUNDEL

DESIGNED BY: D DODA 5-8-75 SIGNAL NO.: 02186

CHECKED BY: *A. Budnick 6-12-75*

DRAWING NO.
TS-1307A